

**SCDHEC OFFICE OF OCEAN AND COASTAL RESOURCE MANAGEMENT
PERMIT APPLICATION PUBLIC NOTICE**

October 30, 2009

Permit Number: OCRM-09-554-S
Permit ID: 68308

The SCDHEC Office of Ocean and Coastal Resource Management has received an application for a permit for the alteration of a critical area. This application was submitted pursuant to the Coastal Zone Management Act (Act 123) of the 1977 South Carolina General Assembly. The application, in brief, is described as follows:

APPLICANT: Terry Grantham
c/o Keith Thompson
148 Middleton Dr
Pawleys Island SC 29585

LOCATION: On and adjacent to South Point Waterway at 1472 Basin Trl, Murrells Inlet, Georgetown County, South Carolina.
TMS#: 41-0128-030-00-00.

WORK: The work, as proposed and shown on the attached plans, consists of moving the existing floating dock and installing a boat lift. Specifically, the applicant requests to move the existing 12' x 40' floating dock 6' channelward and to build a 4' x 6' landing on landward side of the floating dock. The applicant also proposes to install a 14' x 16' boat lift on the floodside of the floating dock. The purpose of the proposed activity is for the applicant's private, recreational use.

This public notice is being distributed to all known interested persons and agencies to assist in developing facts on which a decision by OCRM can be based. Comments concerning the proposed work should be submitted in writing, setting forth sufficient detail to furnish a clear understanding of the reasons for support or opposition.

The decision to issue or deny a permit will be based on the individual merits of the application, the policies specified in the South Carolina Coastal Zone Management Act, and the considerations outlined in the State of South Carolina Coastal Zone Management Program. Interested parties who wish to be notified of final permit action must notify OCRM in writing of this request.

To assure review by OCRM, comments regarding this application must be received by OCRM on or before November 14, 2009. For further information please contact the project manager for this activity, Christopher Stout at 843-238-4528.

PLEASE REPLY TO:

SCDHEC OFFICE OF OCEAN AND COASTAL RESOURCE MANAGEMENT
927 Shine Avenue
Myrtle Beach, SC 29577

Please refer to P/N# OCRM-09-554-S


Christopher Stout, Wetland Project Manager

CRITICAL LINE


From	To	Bearing	Distance
41	35	N 30° 50' 41" E	1.70'
35	36	N 59° 08' 19" W	22.81'
36	37	N 32° 04' 14" E	60.30'
37	40	N 58° 18' 58" E	15.21'

CRITICAL LINE COORDINATES

Number	North	East
41	631659.66'	2803170.34'
35	631661.12'	2803171.22'
36	631672.81'	2803151.63'
37	631723.91'	2803183.66'
40	631731.90'	2803186.58'

CRITICAL LINE WAS CERTIFIED BY Christopher Stout
ON 10/26/2009 ON CRITICAL LINE SURVEY AND AS-BUILT
OF THE AREA WEST OF LOT 56, SOUTH POINT LOTS IN GARDEN CITY
SURVEYED FOR TERRELL W. GRANTHAM BY J. LUCKEY SANDERS,
DATED OCTOBER 06, 2009

PLAN VIEW

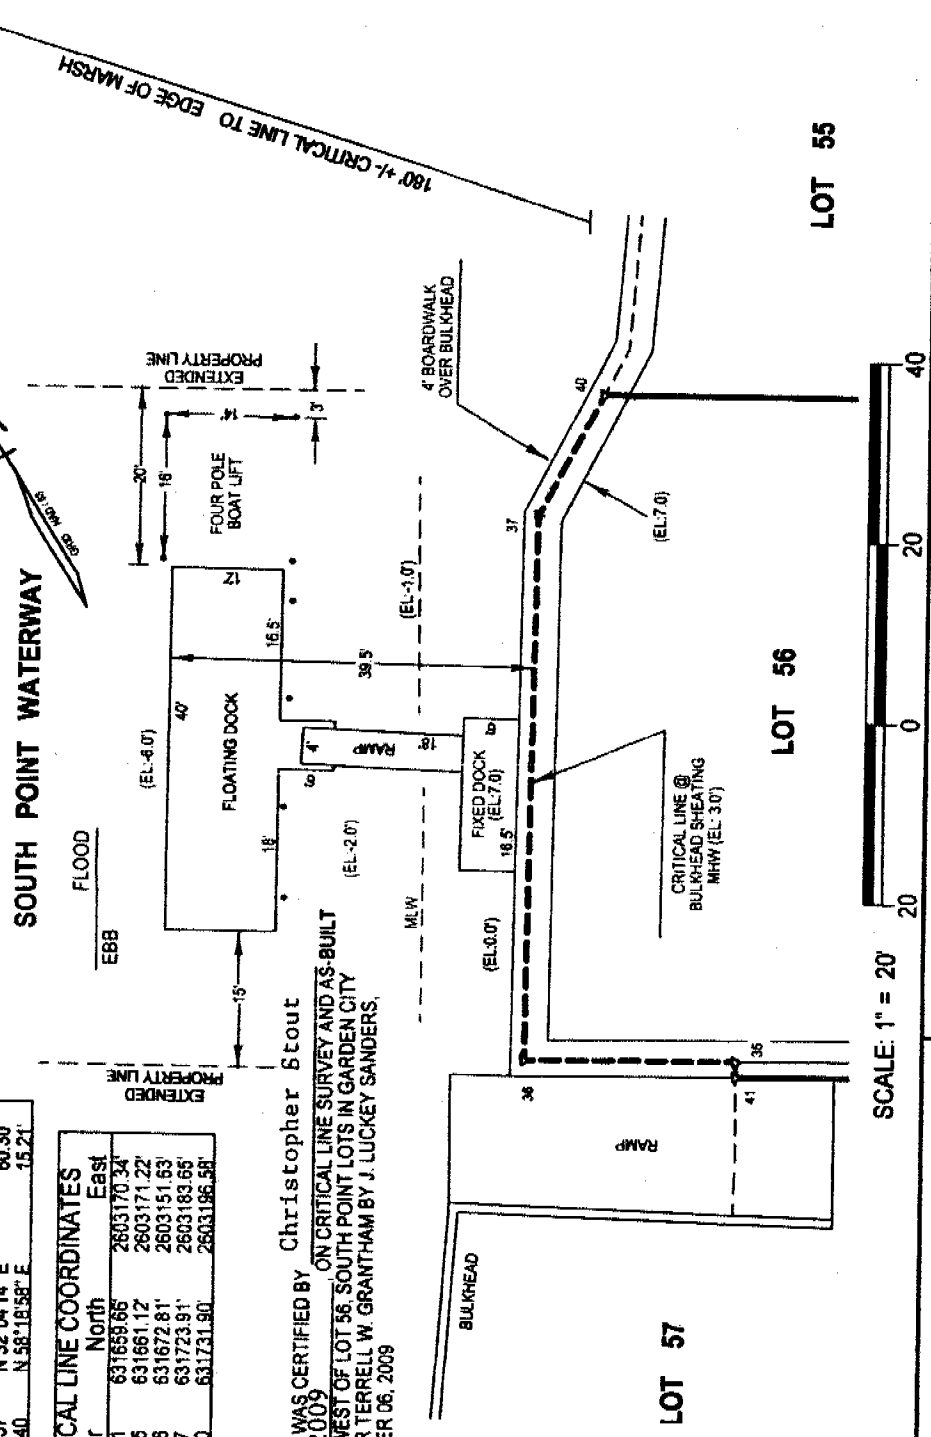

SCALE: 1" = 20'


APPLICANT: TERRELL W. GRANTHAM
ACTIVITY: RELOCATION OF FLOATING DOCK AND FOUR POLE BOAT LIFT ADDITION

LOCATION: OF THE AREA WEST OF LOT 56, SOUTH POINT LOTS IN GARDEN CITY, 1742 BASIN TERRACE
COUNTY: 1772
GEORGETOWN
DATE: OCTOBER 06, 2009

ADJACENT PROPERTY OWNERS:
MIRIAM V. BRICKLE
PATRICIA FOMLAKES PERINICK
PIN # OCRM-09-554-5

PROFILE

180' +/- (CRITICAL LINE TO EDGE OF MARSH)
39.5' (CRITICAL LINE TO END OF FLOATING DOCK)

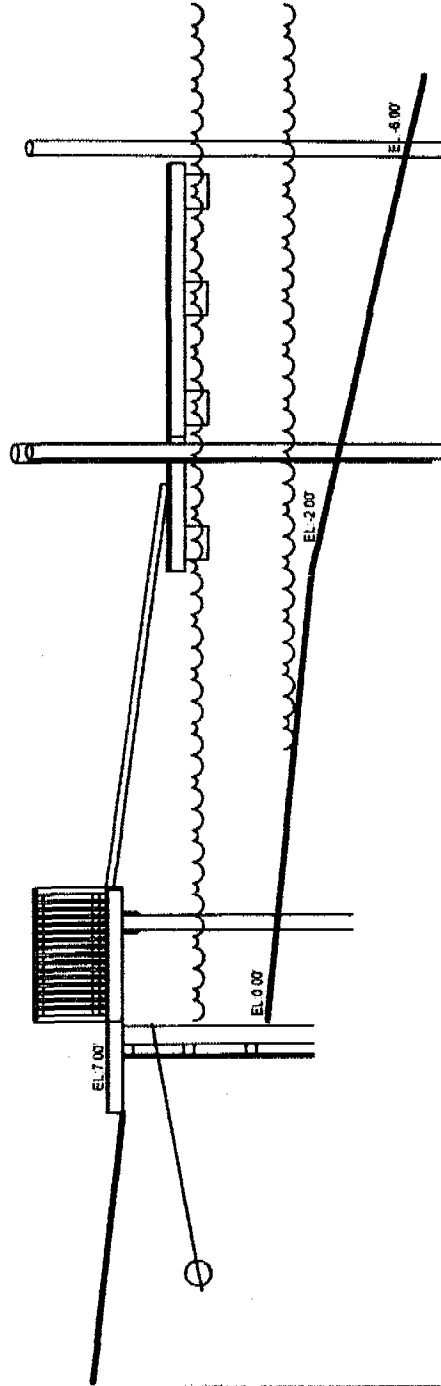

CRITICAL LINE WAS CERTIFIED BY Christopher Stout
ON 10/26/2009 ON CRITICAL LINE SURVEY AND AS-BUILT
OF THE AREA WEST OF LOT 56, SOUTH POINT LOTS IN GARDEN CITY
SURVEYED FOR TERRELL W. GRANTHAM BY J. LUCKEY SANDERS,
DATED OCTOBER 06, 2009

SCALE: 1" = 20'

APPLICANT:

TERRELL W. GRANTHAM

ACTIVITY:

RELOCATION OF FLOATING DOCK AND
FOUR POLE BOAT LIFT ADDITION

PIN #

OCR-M-09-534-S

LOCATION:

OF THE AREA WEST OF LOT 56, SOUTH POINT LOTS IN
GARDEN CITY, 4442 BASIN TERRACE

COUNTY:

GEORGETOWN

DATE:


OCTOBER 06, 2009

ADJACENT PROPERTY OWNERS:

MIRIAM V. BRICKLE

PATRICIA FOWLES PERNICK


Phyllis

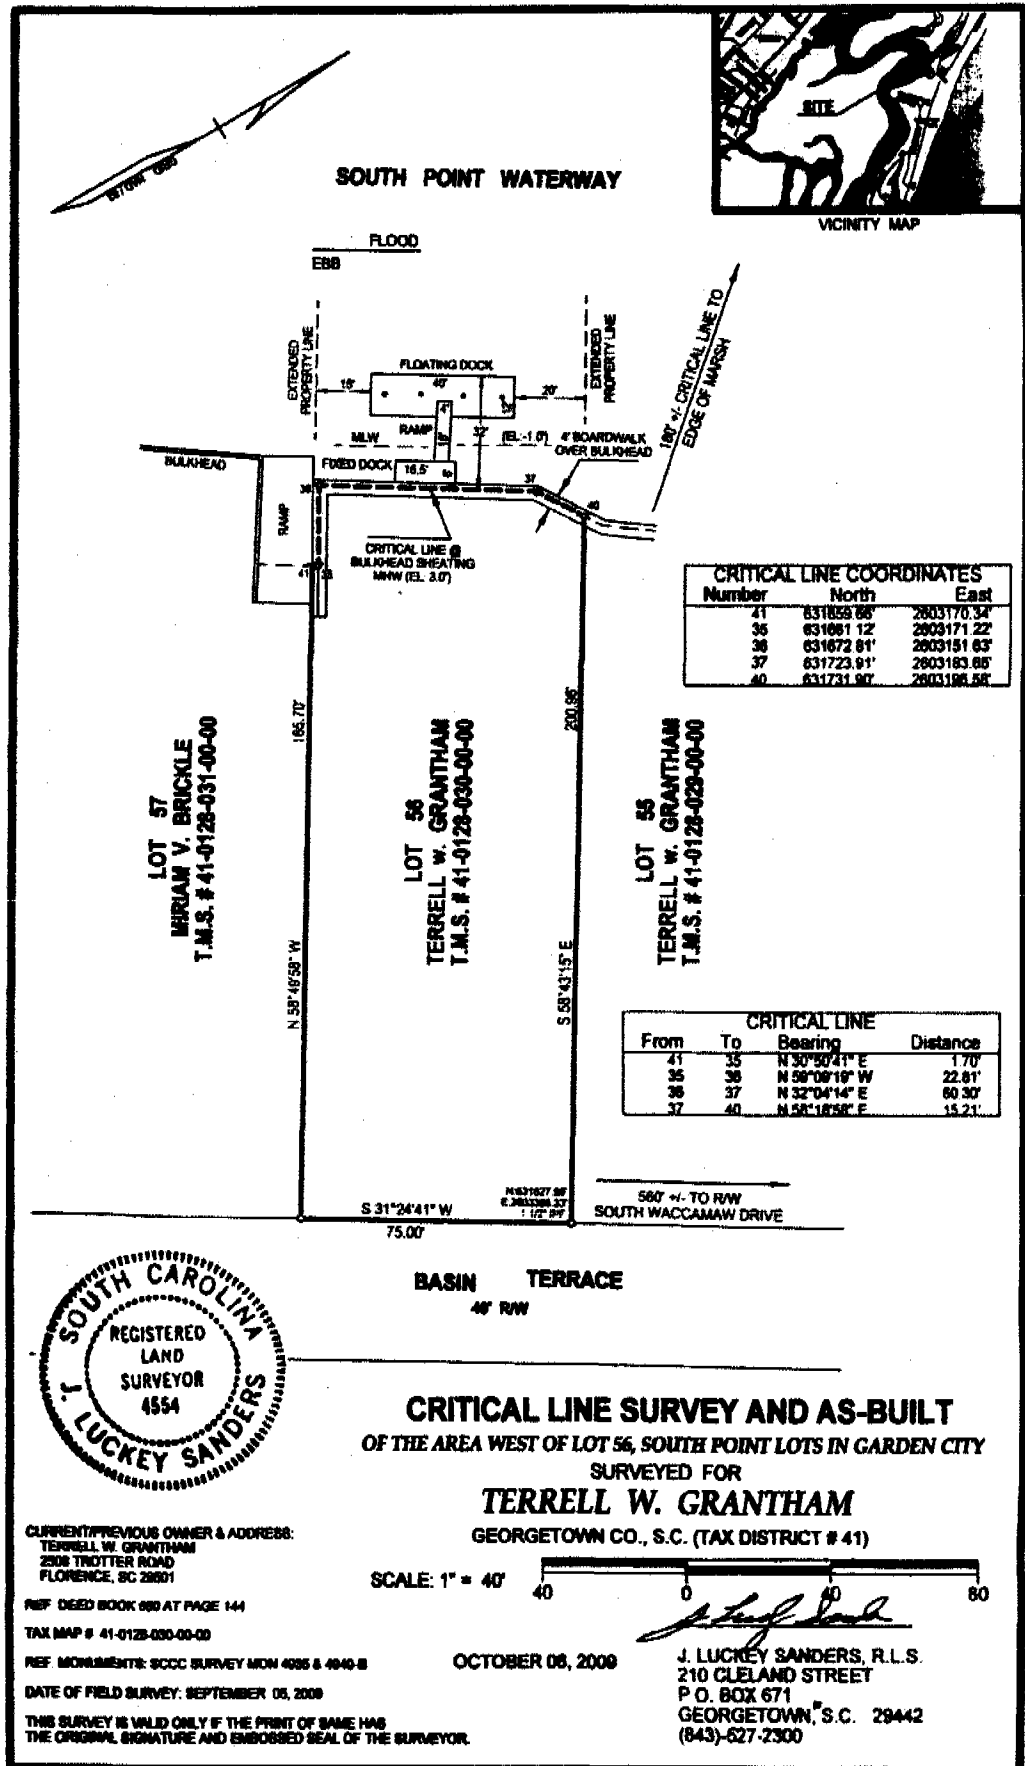

Not To Scale

OURM-09-554-S

VICINITY MAP

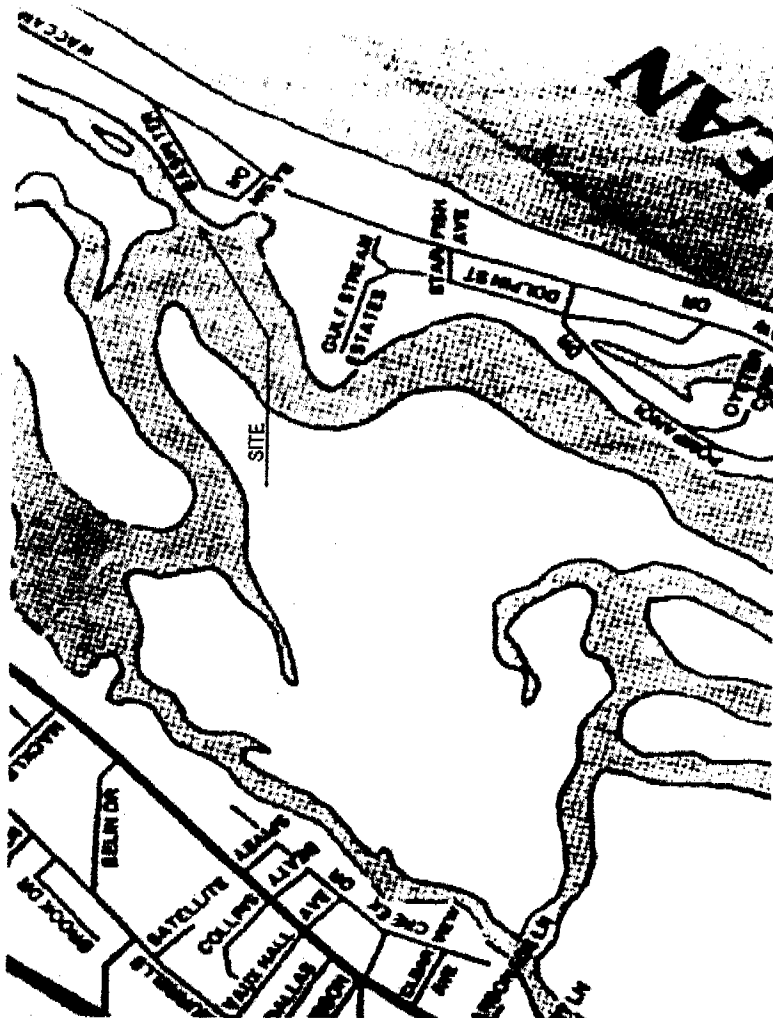

APPLICANT:

TERRELL W. GRANTHAM

ACTIVITY:

RELOCATION OF FLOATING DOCK AND FOUR POLE BOAT LIFT ADDITION

PIN 1

OCRM-09-554-S

LOCATION:

OF THE AREA WEST OF LOT 56, SOUTH POINT LOTS IN
GARDEN CITY - 1742-BASIN TERRACE

COUNTY:

22

GEORGETOWN

DATE:

OCTOBER 06, 2009

ADJACENT PROPERTY OWNERS:

MIRIAM V. BRICKLE

PATRICIA FOWLES PERNICK

Prof. Sach

